


[illegible]

REVISIONS			
SYS#	DESCRIPTION	DATE	APPROVAL
A ₁	A ₁ -ADDED RIBS(2) TO HUB	6-APR-66	6-00184
A ₂	A ₂ -RELOCATED DIMENSION	6-APR-66	REV'D 6-2-66 P.C.E. mfb

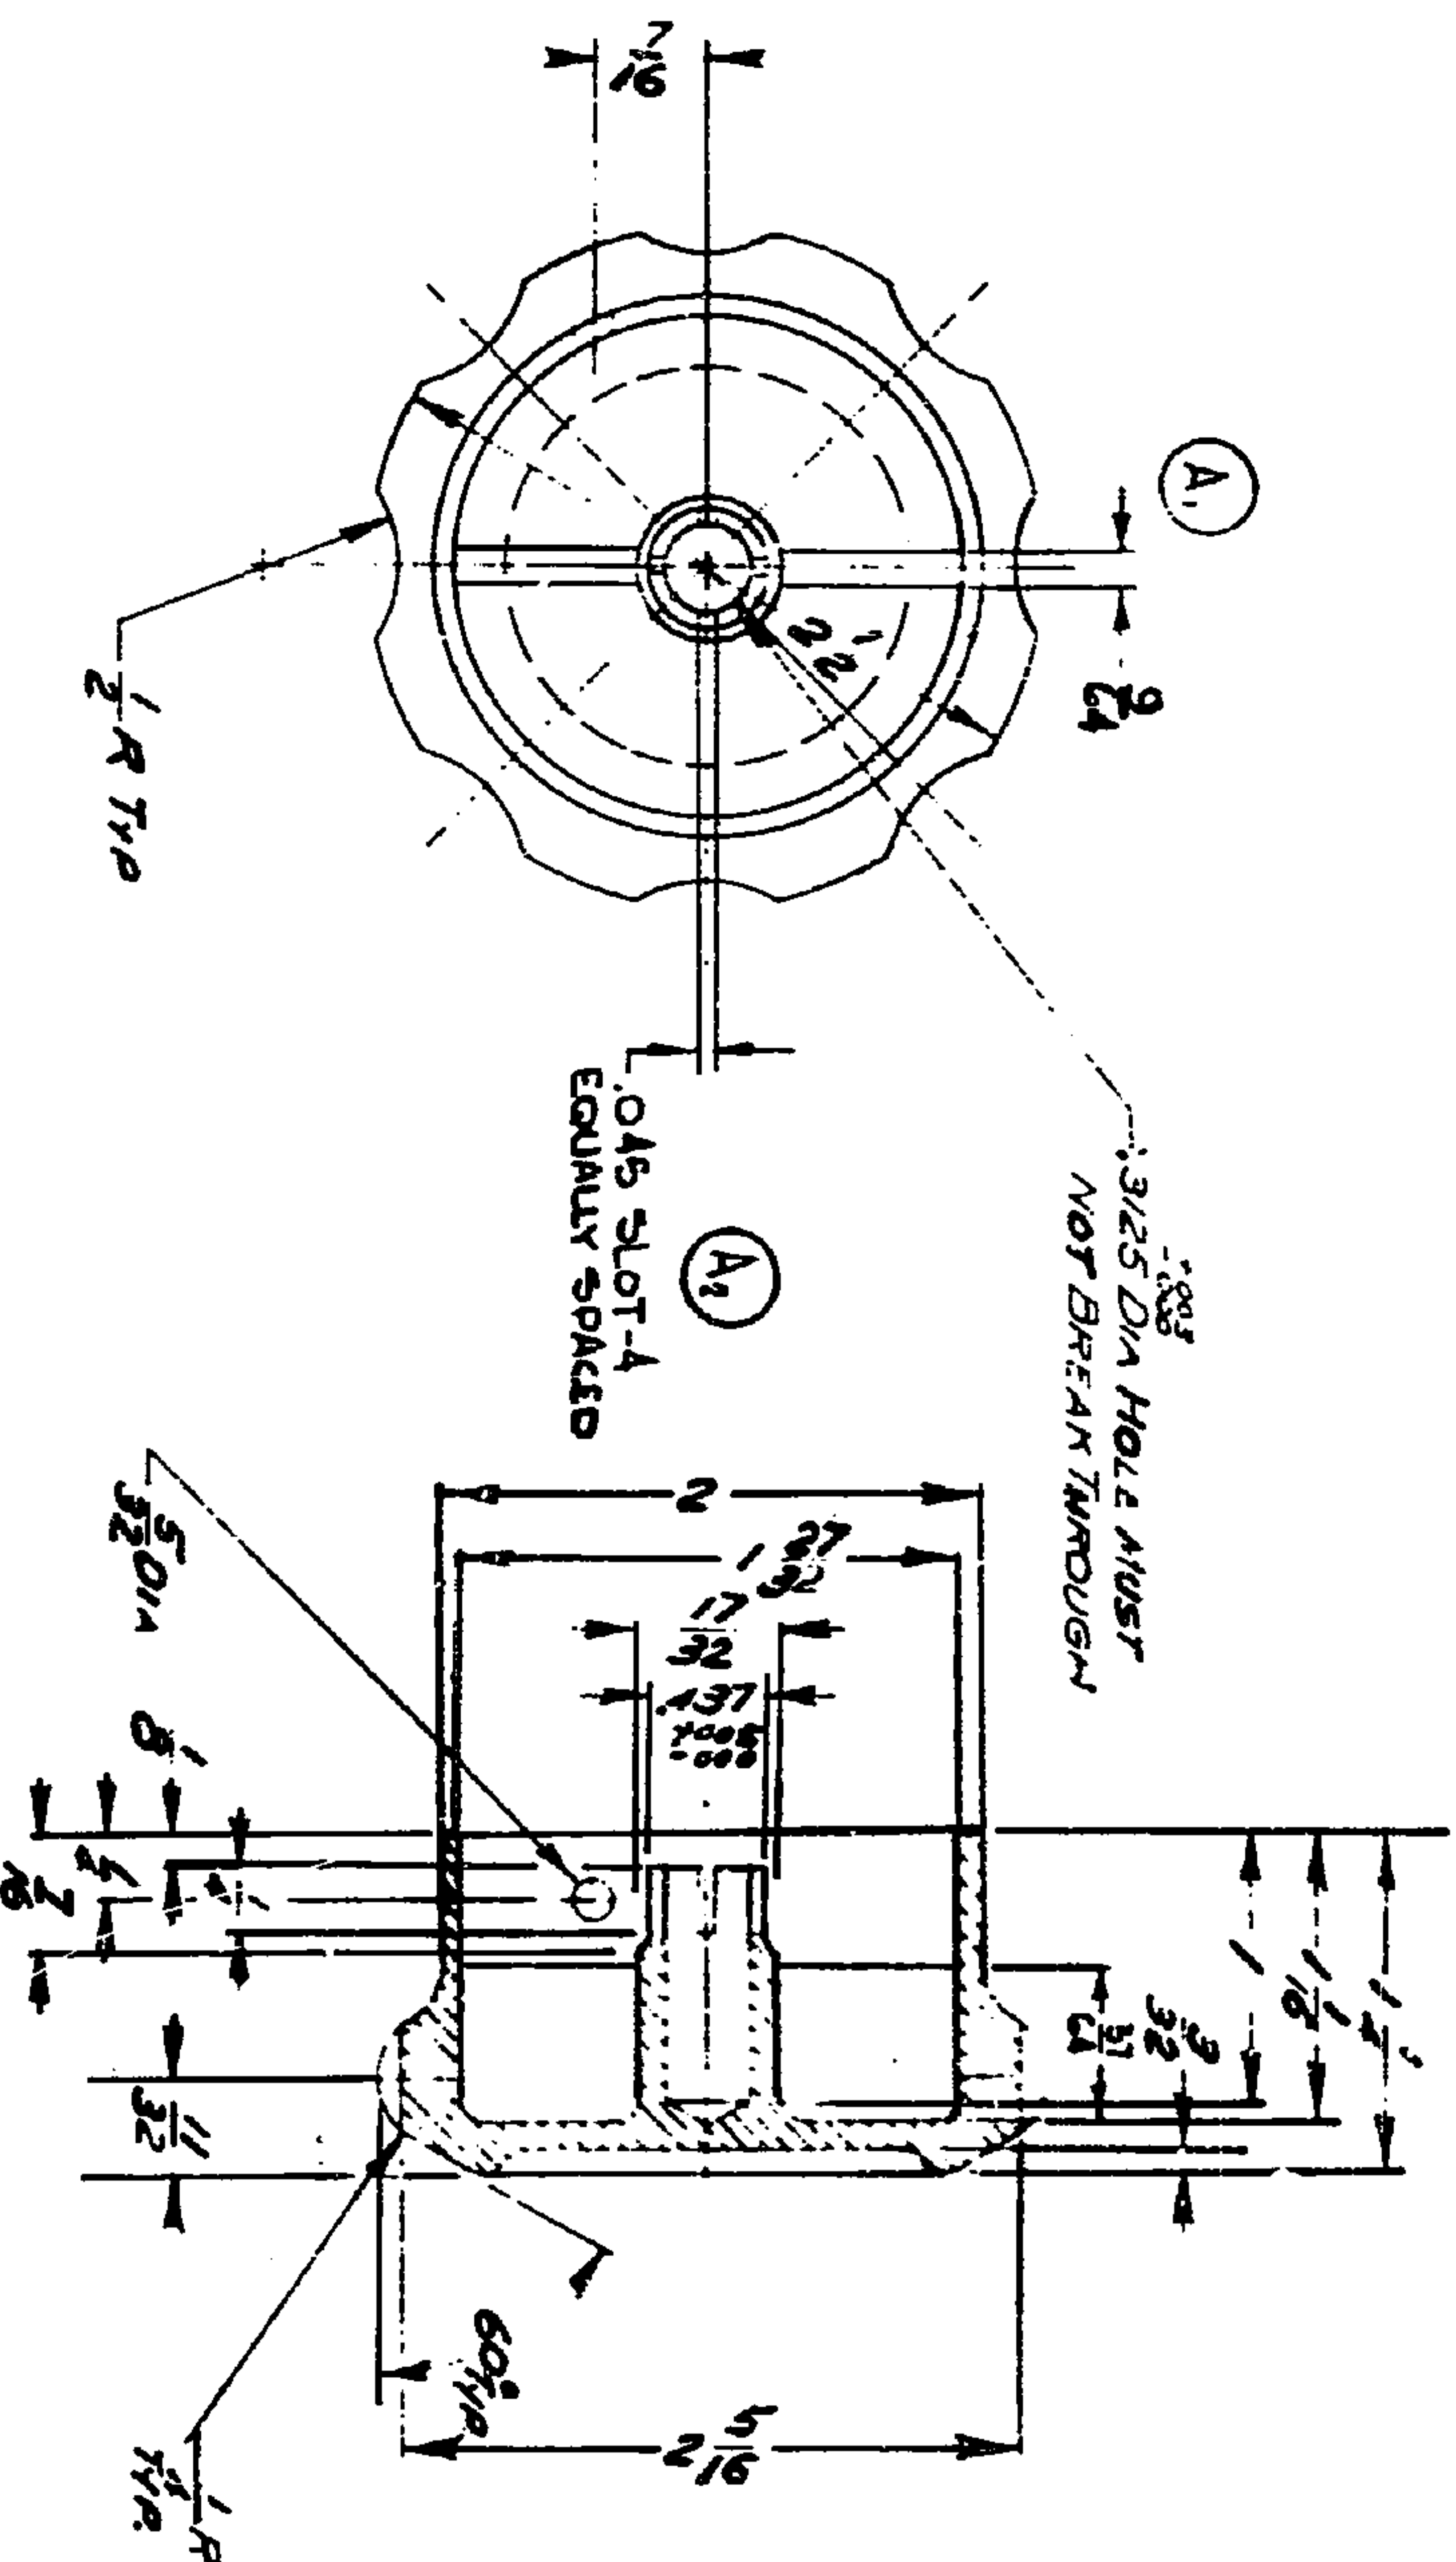

NOTES:
1. PART MADE BY SUPERHEATED STEAM
CHARLES CARP CHICAGO, ILL. CAP EQUIVAL
PERFORMING 17 METERS THE FOLLOWING
REQUIREMENTS 5' DIMENSIONS 500 MM.
MAINTENANCE: RECOMMEND BRASS ALLOY DIE
CAST USING RECOMMEND ALLOY NO 13
IN ACCORDANCE WITH FEDERAL SPEC
QQ-A-591.
FINISH: P516 D F&P SPEC. MIL. T-14072.

~~EAC NO. 1500-0325~~

[illegible]

LIST OF MATERIAL

~~BOOKING PART NO. 5570183~~ 5570183 11022

DRAWN F. E. F.		CHECKED <i>[Signature]</i>		APPROVED	
UNLESS OTHERWISE SPECIFIED: USUAL DIMENSIONS INCLUDING HOLE SIZES MAY VARY ± .015 PRACTICAL DIMENSIONS INCLUDING HOLE SIZES MAY VARY ± .004 MACHINED ANGLES MAY VARY ± .5° SHEARED ANGLES MAY VARY ± .25° BROKEN ANGLES MAY VARY ± .125° SCREWED ANGLES MAY VARY ± .125° ALL DIMENSIONS ARE FINISH DIMENSIONS INCLUDING APPLICABLE FINISH AND ARE GIVEN IN INCHES					
COLLINS RADIO CO. 4214-PA-5193		REVIEWED PME		DATE: 12 JAN '56	
SIGNAL CORPS		APPROVED HLY		SCALE 1/1	
KNOB - TUNING		APPROVED PME		DATE: 12 JAN '56	
DEPARTMENT OF THE ARMY SIGNAL CORPS ENGINEERING LABORATORIES		FORT MONMOUTH NEW JERSEY		SM-B-249243	